FLOOR 15


VIEW OF CENTRAL PARK / UPPER EAST SIDE


E. 61ST STREET

15th FLOOR (PARTIAL) 2,500 RSF

AVAILABLE NOVEMBER 1, 2023

AS-BUILT PLAN — PRE-BUILT INSTALLATION

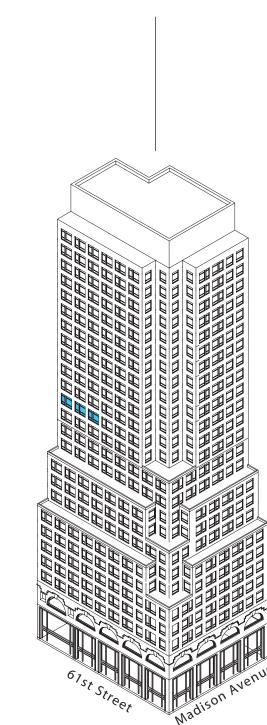

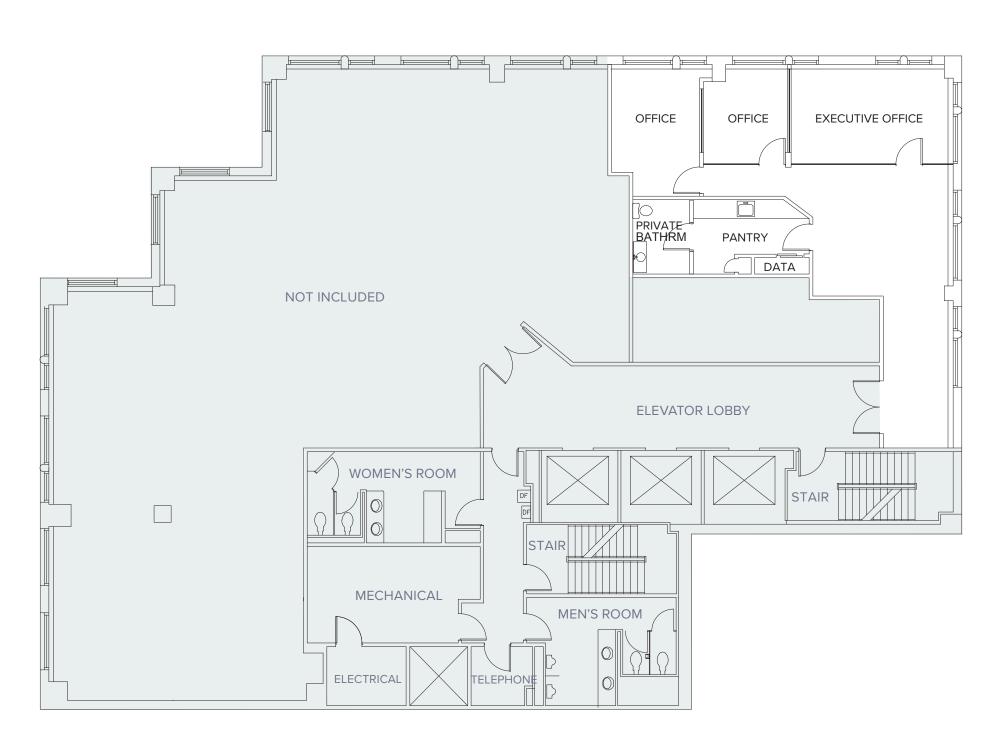

MADISON AVENUE

VIEW OF CENTRAL PARK / MIDTOWN

