

FLOOR 19

SUPER VIEWS OF CENTRAL PARK / UPPER EAST SIDE

E. 61ST STREET


AVAILABLE IMMEDIATELY

19TH FLOOR
8,460 RSF

AS-BUILT PLAN

SUPER VIEWS OF CENTRAL PARK / UPPER EAST SIDE

MADISON AVENUE

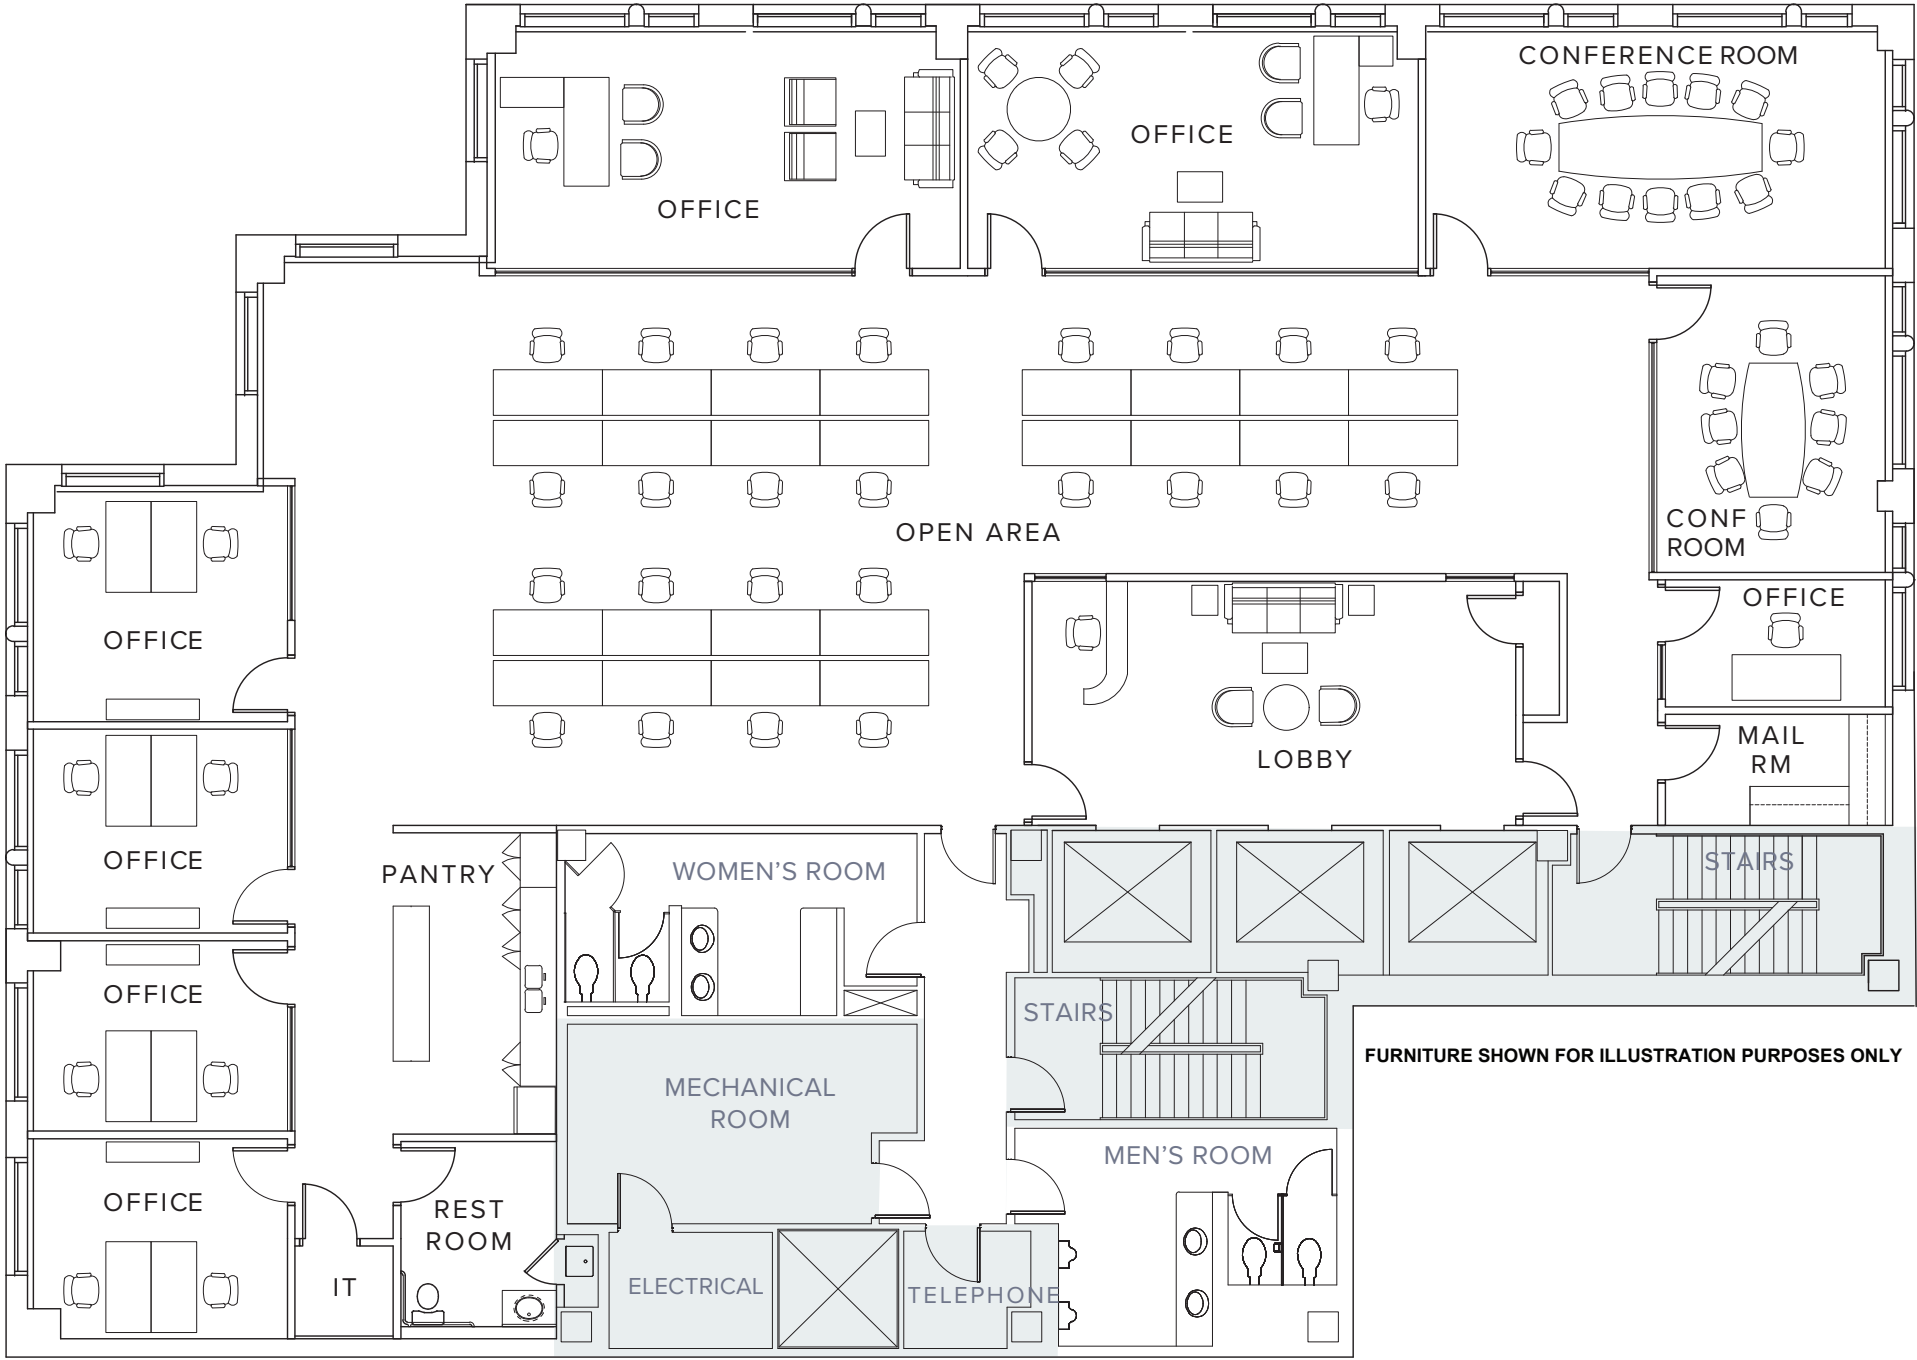

FURNITURE SHOWN FOR ILLUSTRATION PURPOSES ONLY

